



**ASTM E 90 SOUND TRANSMISSION LOSS  
TEST REPORT**

**Rendered to:**

**C.R. LAURENCE CO., INC.**

**SERIES/MODEL: 8200**

**TYPE: Horizontal Sliding Window**

| <b>Summary of Test Results</b> |  |            |             |
|--------------------------------|--|------------|-------------|
| <b>Data File No.</b>           | <b>Glazing (Nominal Dimensions)</b>                  | <b>STC</b> | <b>OITC</b> |
| E2738.01                       | 1" IG (1/4" tempered, 1/2" air space, 1/4" tempered) | 32         | 26          |

Reference should be made to Architectural Testing, Inc. Report No. E2738.01-113-11 for complete test specimen description. The complete test results are listed in Appendix B.



## ACOUSTICAL PERFORMANCE TEST REPORT

Rendered to:

C.R. LAURENCE CO., INC.  
2100 East 38th Street  
Vernon, California 90058

Report No: E2738.01-113-11  
Test Date: 12/30/14  
Report Date: 01/30/15

### **Test Sample Identification:**

**Series/Model:** 8200

**Type:** Horizontal Sliding Window

**Overall Size:** 59" by 47-1/4"

**Glazing (Nominal Dimensions):** 1" IG (1/4" Tempered, 1/2" Air Space, 1/4" Tempered)

**Project Scope:** Architectural Testing, Inc. was contracted by C.R. Laurence Co., Inc. to conduct a sound transmission loss test on a Series/Model 8200, Horizontal sliding window. A summary of the results is listed in the Test Results section, and the complete test data is included as Appendix B of this report. The sample was provided by the client.

**Test Methods:** The acoustical tests were conducted in accordance with the following:

ASTM E 90-09, *Standard Test Method for Laboratory Measurement of Airborne Sound Transmission Loss of Building Partitions.*

ASTM E 413-10, *Classification for Rating Sound Insulation.*

ASTM E 1332-10a, *Standard Classification for Rating Outdoor-Indoor Sound Attenuation.*

ASTM E 2235-04 (Reapproved 2012), *Standard Test Method for Determination of Decay Rates for Use in Sound Insulation Test Methods.*

**Test Equipment:** The equipment used to conduct these tests meets the requirements of ASTM E 90. The microphones were calibrated before conducting sound transmission loss tests. The test equipment and test chamber descriptions are listed in Appendix A.

**Sample Installation:** A double stud filler wall was constructed with 2-1/2" steel studs and 3-1/2" steel studs spaced 24" on center. Five layers of 5/8" Type "X" gypsum board were fastened to the receive side of the filler wall. Three layers of 1/2" cement board were fastened to the source side of the filler wall. The cavity was filled with two layers of R-13 fiberglass insulation. The perimeter and seams were sealed with acoustical sealant. A sound transmission loss test was then conducted on the filler wall. The filler wall achieved an STC rating of 71. The 60-1/2" by 48-1/2" filler wall plug was removed.

A filler wall-reducing element was built to adjust the test opening size to accommodate the test specimen. The reducing element consisted of a double 2x4 wood stud wall construction with three layers of 5/8" drywall on both sides. The stud cavities in the wall were insulated with two layers of R-13 fiberglass insulation. The window system was placed on isolation pads in the test opening. Duct seal was used to seal the perimeter of the test specimen to the test opening on both sides. The interior side of the test specimen, when installed, was approximately 1/4" from being flush with the receiving room side of the filler wall. A stethoscope was used to check for any abnormal air leaks around the test specimen prior to testing. The vent was opened and closed at least five times prior to testing.

**Sample Descriptions:**

**Frame Construction:**

|                              |                        | <b>Frame</b>   |
|------------------------------|------------------------|----------------|
| <b>Size</b>                  |                        | 59" by 47-1/4" |
| <b>Thickness</b>             |                        | 4-1/2"         |
| <b>Corners</b>               |                        | Coped          |
|                              | Fasteners              | Screws         |
|                              | Seal Method            | Sealant        |
| <b>Material</b>              |                        | Aluminum       |
|                              | Reinforcement          | N/A            |
|                              | Thermal Break Material | Urethane       |
| <b>Daylight Opening Size</b> |                        | 25-3/8" by 38" |

*N/A-Non Applicable*

**Sample Descriptions:** (Continued)

**Panel Construction:**

|                              |                        | <b>Active Panel</b> |
|------------------------------|------------------------|---------------------|
| <b>Size</b>                  |                        | 30-1/4" by 42-3/4"  |
| <b>Thickness</b>             |                        | 1-7/8"              |
| <b>Corners</b>               |                        | Coped               |
|                              | Fasteners              | Screws              |
|                              | Seal Method            | Sealant             |
| <b>Material</b>              |                        | Aluminum            |
|                              | Reinforcement          | N/A                 |
|                              | Thermal Break Material | Urethane            |
| <b>Daylight Opening Size</b> |                        | 25-3/8" by 38"      |

**Glazing:**

|   |          |
|---|----------|
| <b>Measured Overall Insulation Glass Unit Thickness</b> | 0.940"   |
| <b>Spacer Type</b>                                      | Aluminum |

|                           | <b>Exterior Sheet</b> | <b>Gap</b> | <b>Interior Sheet</b> |
|---------------------------|-----------------------|------------|-----------------------|
| <b>Measured Thickness</b> | 0.222"                | 0.498"     | 0.220"                |
| <b>Muntin Pattern</b>     | N/A                   | N/A        | N/A                   |
| <b>Material</b>           | Tempered              | Air*       | Tempered              |
| <b>Laminate Material</b>  | N/A                   | N/A        | N/A                   |

|                              |                       |
|------------------------------|-----------------------|
| <b>Glazing Method</b>        | Interior              |
| <b>Glazing Material</b>      | Flexible wedge gasket |
| <b>Glazing Bead Material</b> | Aluminum              |

\* - Stated per Client/Manufacturer, N/A-Non Applicable

**Sample Descriptions:** (Continued)

**Components:**

| TYPE                                      | QUANTITY | LOCATION                            |
|---|----------|-------------------------------------|
| <b>Weatherstrip</b>                       |          |                                     |
| 0.270" by 0.270" Polypile with triple fin | 1 Row    | Perimeter of frame and meeting rail |
| <b>Hardware</b>                           |          |                                     |
| Roller wheel assembly set                 | 1        | Bottom rail                         |
| Spring loaded latch                       | 1        | Lock stile                          |
| Keeper                                    | 1        | Keeper stile                        |
| Weep cover                                | 2        | Sill face                           |
| Handle bar                                | 2        | Lock rail and stile                 |
| <b>Drainage</b>                           |          |                                     |
| 1-3/4" by 1/4" Weep slot                  | 2        | Sill face                           |
| 2" by 1/2" Weep slot                      | 2        | Sill track                          |

**Comments:** The total weight of the sample was 158 lbs. The design drawings (included in Appendix C) supplied by the client, accurately describe the Series/Model 8200, Horizontal sliding window. The dimensions on the drawings that are circled and/or checked were verified against the test specimen. The window was disassembled, and the components will be retained by Architectural Testing for four years. Photographs of the test specimen are included in Appendix D.

**Test Results:** The STC (Sound Transmission Class) rating was calculated in accordance with ASTM E 413. The OITC (Outdoor-Indoor Transmission Class) was calculated in accordance with ASTM E 1332. A summary of the sound transmission loss test results on the Series/Model 8200, Horizontal sliding window is listed below.

| <b>Summary of Test Results</b> |  |            |             |
|--------------------------------|--|------------|-------------|
| <b>Data File No.</b>           | <b>Glazing (Nominal Dimensions)</b>                  | <b>STC</b> | <b>OITC</b> |
| E2738.01                       | 1" IG (1/4" tempered, 1/2" air space, 1/4" tempered) | 32         | 26          |

The complete test results are listed in Appendix B. Flanking limit tests and reference specimen tests are available upon request.

Architectural Testing will service this report for the entire test record retention period. Test records, such as detailed drawings, datasheets, representative samples of test specimens, or other pertinent project documentation, will be retained by Architectural Testing for the entire test record retention period. The test record retention period ends four years after the test date.

This report does not constitute certification of this product nor an opinion or endorsement by this laboratory. It is the exclusive property of the client so named herein and relates only to the specimen tested. This report may not be reproduced, except in full, without the written approval of Architectural Testing.

For ARCHITECTURAL TESTING, INC:

---

Zachary Golden  
Technician - Acoustical Testing

---

Todd D. Kister  
Laboratory Supervisor - Acoustical Testing

ZPG:jmcs

Attachments (pages): This report is complete only when all attachments listed are included.

- Appendix-A: Equipment description (1)
- Appendix-B: Complete test results (2)
- Appendix-C: Design drawings (6)
- Appendix-D: Photographs (1)



### Revision Log

| <u>Rev. #</u> | <u>Date</u> | <u>Page(s)</u> | <u>Revision(s)</u>    |
|---------------|-------------|----------------|-----------------------|
| 0             | 01/30/15    | N/A            | Original Report Issue |



E2738.01 -113-11

## Appendix A

### Instrumentation:

| Instrument                           | Manufacturer         | Model    | Description                     | ATI Number | Date of Calibration |
|--------------------------------------|----------------------|----------|---------------------------------|------------|---------------------|
| Data Acquisition Unit                | National Instruments | PXI-1033 | Data Acquisition card           | 65127      | 04/14 *             |
| Source Room Microphone               | PCB Piezotronics     | 378B20   | Microphone and Preamplifier     | 64902      | 12/14               |
| Source Room Microphone               | PCB Piezotronics     | 378B20   | Microphone and Preamplifier     | 64903      | 12/14               |
| Source Room Microphone               | PCB Electronics      | 378B20   | Microphone and Preamplifier     | 65103      | 05/14               |
| Source Room Microphone               | PCB Piezotronics     | 378B20   | Microphone and Preamplifier     | 64905      | 12/14               |
| Source Room Microphone               | PCB Piezotronics     | 378B20   | Microphone and Preamplifier     | 64906      | 12/14               |
| Receive Room Microphone              | PBC Piezotronics     | 378B20   | Microphone and Preamplifier     | 64907      | 11/14               |
| Receive Room Microphone              | PCB Piezotronics     | 378B20   | Microphone and Preamplifier     | 64908      | 11/14               |
| Receive Room Microphone              | PCB Piezotronics     | 378B20   | Microphone and Preamplifier     | 64909      | 11/14               |
| Receive Room Microphone              | PCB Piezotronics     | 378B20   | Microphone and Preamplifier     | 64910      | 11/14               |
| Receive Room Microphone              | PCB Piezotronics     | 378B20   | Microphone and Preamplifier     | 64911      | 11/14               |
| Receive Room Environmental Indicator | Vaisala              | HMW92    | Temperature Humidity Sensor     | 64286      | 06/14               |
| Source Room Environmental Indicator  | Vaisala              | HMW60Y   | Temperature and Humidity Sensor | Y002653    | 06/14               |
| Microphone Calibrator                | Norsonic             | 1251     | Pistonphone Calibrator          | 65105      | 04/14               |

\*- Note: The calibration frequency for this equipment is every two years per the manufacturer's recommendation.

### Test Chamber:

|              | Volume   | Description   |
|--------------|--|---|
| Receive Room | 234 m <sup>3</sup> (8291.3 ft <sup>3</sup> )   | Rotating vane and stationary diffusers<br>Temperature and humidity controlled<br>Isolation pads under the floor |
| Source Room  | 206.6 m <sup>3</sup> (7296.3 ft <sup>3</sup> ) | Stationary diffusers only<br>Temperature and humidity controlled  |

|                 | Maximum Size                                  | Description                                      |
|-----------------|---|--|
| TL Test Opening | 4.27 m (14 ft) wide by<br>3.05 m (10 ft) high | Vibration break between source and receive rooms |

N/A-Non Applicable





E2738.01-113-11

**Appendix B**  
**Complete Test Results**



**AIRBORNE SOUND TRANSMISSION LOSS**  
ASTM E 90

|                      |   |                  |         |  |                 |         |
|----------------------|---|------------------|---------|--|-----------------|---------|
| <b>Test Date</b>     | 12/30/14  |                  |         |  |                 |         |
| <b>Data File No.</b> | E2738.01  |                  |         |  |                 |         |
| <b>Client</b>        | C.R. Laurence Co., Inc.   |                  |         |  |                 |         |
| <b>Description</b>   | Series/Model: 8200, Horizontal sliding window with 1" IG (1/4" tempered, 1/2" air space, 1/4" tempered) |                  |         |  |                 |         |
| <b>Specimen Area</b> | 1.80 m <sup>2</sup>   | Receive Temp.    | 23.6 °C |  | Source Temp.    | 24.0 °C |
| <b>Technician</b>    | Zach Golden   | Receive Humidity | 51%     |  | Source Humidity | 50%     |

| Freq<br>(Hz) | Background<br>SPL<br>(dB) | Absorption<br>(m <sup>2</sup> ) | Source<br>SPL<br>(dB) | Receive<br>SPL<br>(dB) | Specimen<br>TL<br>(dB) | 95%<br>Confidence<br>Limit | Number<br>of<br>Deficiencies |
|--------------|---------------------------|---------------------------------|-----------------------|------------------------|------------------------|----------------------------|------------------------------|
| 80           | 34.4                      | 3.7                             | 108                   | 81                     | 24.4                   | 4.49                       | -                            |
| 100          | 32.7                      | 4.8                             | 108                   | 80                     | 24.0                   | 1.70                       | -                            |
| 125          | 34.9                      | 5.0                             | 107                   | 87                     | 15.2                   | 1.64                       | 1                            |
| 160          | 39.6                      | 4.7                             | 107                   | 82                     | 20.4                   | 0.74                       | 0                            |
| 200          | 38.4                      | 4.7                             | 107                   | 82                     | 21.5                   | 0.69                       | 1                            |
| 250          | 32.4                      | 5.2                             | 108                   | 79                     | 24.5                   | 0.77                       | 0                            |
| 315          | 26.7                      | 6.2                             | 103                   | 74                     | 23.4                   | 0.47                       | 5                            |
| 400          | 24.4                      | 6.6                             | 102                   | 71                     | 25.0                   | 0.44                       | 6                            |
| 500          | 21.9                      | 6.5                             | 102                   | 67                     | 29.4                   | 0.48                       | 3                            |
| 630          | 18.0                      | 6.4                             | 103                   | 66                     | 31.9                   | 0.25                       | 1                            |
| 800          | 14.9                      | 6.6                             | 103                   | 64                     | 32.9                   | 0.31                       | 1                            |
| 1000         | 10.7                      | 6.6                             | 102                   | 61                     | 34.7                   | 0.25                       | 0                            |
| 1250         | 9.3                       | 7.3                             | 100                   | 58                     | 35.9                   | 0.26                       | 0                            |
| 1600         | 6.9                       | 7.7                             | 103                   | 61                     | 35.9                   | 0.21                       | 0                            |
| 2000         | 5.8                       | 8.0                             | 101                   | 62                     | 32.3                   | 0.25                       | 4                            |
| 2500         | 5.2                       | 8.9                             | 100                   | 60                     | 33.0                   | 0.16                       | 3                            |
| 3150         | 5.1                       | 10.4                            | 100                   | 59                     | 33.7                   | 0.14                       | 2                            |
| 4000         | 5.4                       | 12.3                            | 99                    | 55                     | 35.6                   | 0.17                       | 0                            |
| 5000         | 5.9                       | 15.2                            | 98                    | 51                     | 37.1                   | 0.29                       | -                            |


**STC Rating**            **32**            *(Sound Transmission Class)*  
**Deficiencies**            **27**            *(Sum of Deficiencies)*  
**OITC Rating**            **26**            *(Outdoor-Indoor Transmission Class)*

**Notes:**  
1) Receive Room levels less than 5 dB above the Background levels are highlighted in yellow.  
2) Specimen TL levels listed in red indicate the lower limit of the transmission loss.  
3) Specimen TL levels listed in green indicate that there has been a filler wall correction applied



**AIRBORNE SOUND TRANSMISSION LOSS**  
ASTM E 90


|                      |   |                  |         |                 |         |  |
|----------------------|---|------------------|---------|-----------------|---------|--|
| <b>Test Date</b>     | 12/30/14  |                  |         |                 |         |  |
| <b>Data File No.</b> | E2738.01  |                  |         |                 |         |  |
| <b>Client</b>        | C.R. Laurence Co., Inc.   |                  |         |                 |         |  |
| <b>Description</b>   | Series/Model: 8200, Horizontal sliding window with 1" IG (1/4" tempered, 1/2" air space, 1/4" tempered) |                  |         |                 |         |  |
| <b>Specimen Area</b> | 1.80 m <sup>2</sup>   | Receive Temp.    | 23.6 °C | Source Temp.    | 24.0 °C |  |
| <b>Technician</b>    | Zach Golden   | Receive Humidity | 51%     | Source Humidity | 50%     |  |

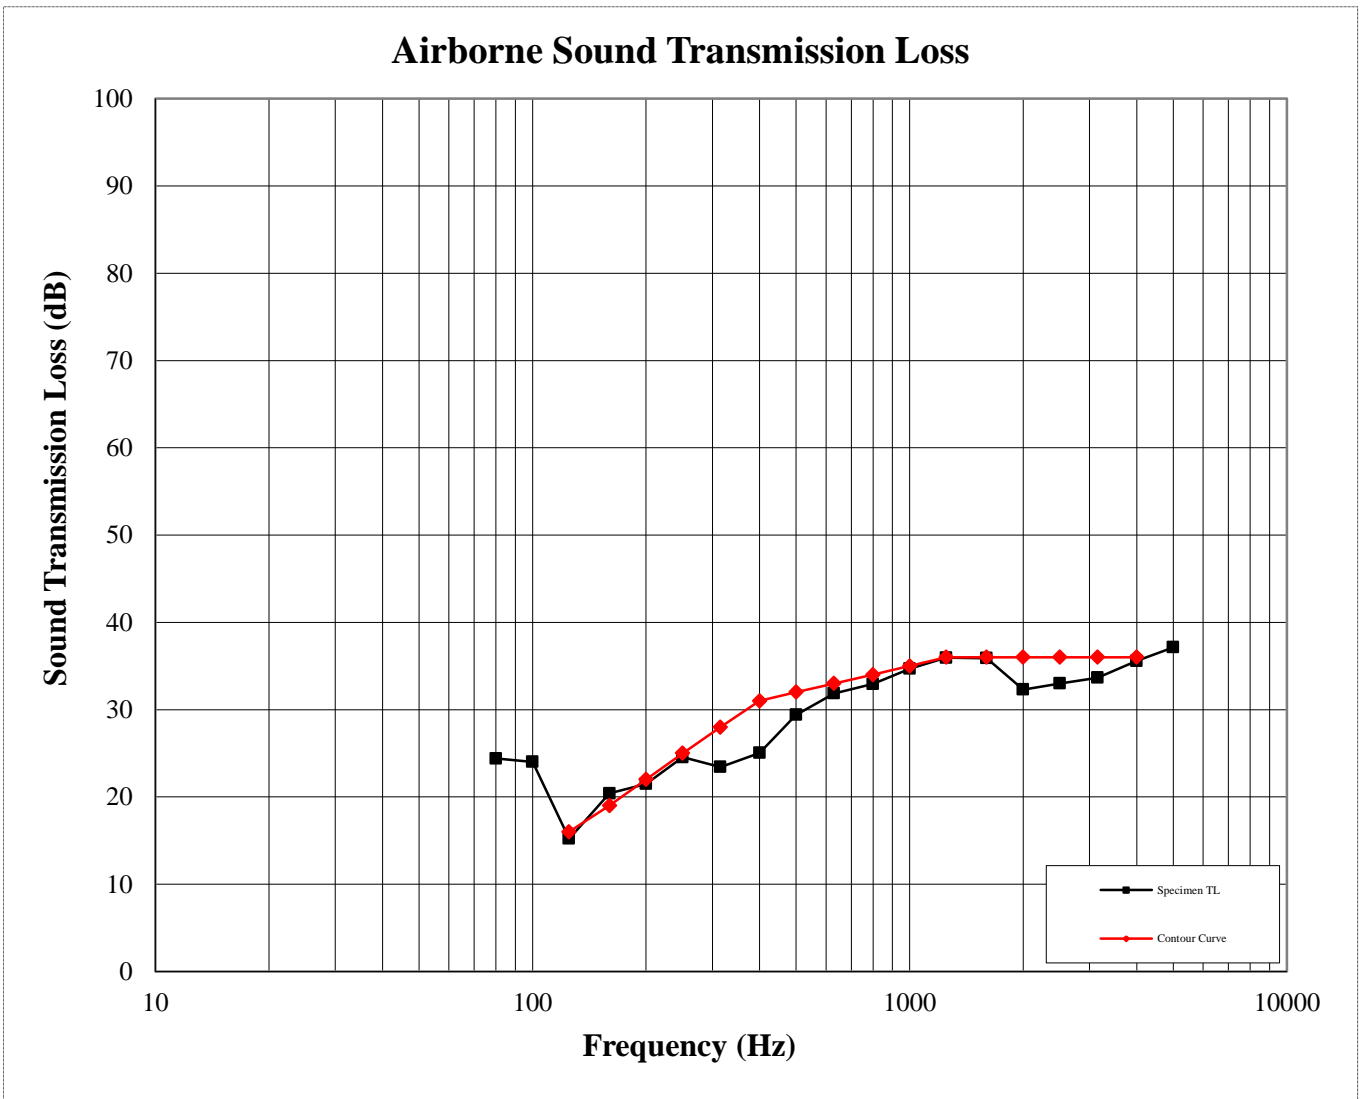



E2738.01-113-11

**Appendix C**  
**Design Drawings**

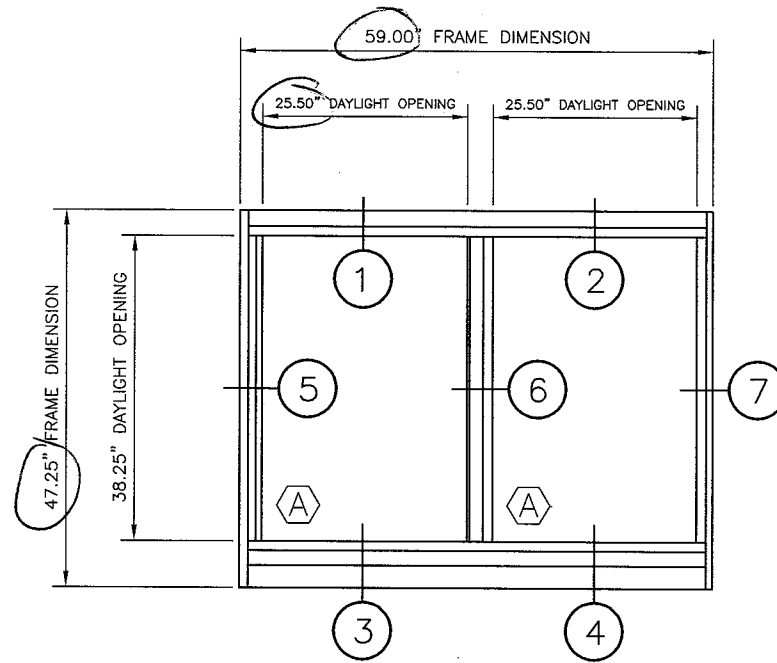

Test sample complies with these details.  
Deviations are noted.

Report# 22738.01-113-11  
Date 1/27/15 Tech ZPK

| SYMBOL KEY |   |      |
|------------|---|------|
| SYMBOL     | DESCRIPTION   | QTY. |
| (A)        | 1" INSULATED GLASS 27.500 X 40.250<br>.250 CLR, TEMPERED<br>.500 MILL ALUM SPACER, AIR<br>.250 PPG SOLARBAN 70XL,<br>LOW-E #3 SURFACE, SILICONE | 2    |

| REV. | DESCRIPTION | DATE | BY |
|------|-------------|------|----|
|      |             |      |    |
|      |             |      |    |
|      |             |      |    |
|      |             |      |    |

THIS DRAWING AND THE DESIGN SHOWN  
THEREIN IS THE PROPERTY OF  
C.R. LAURENCE CO., INC.  
AND USE OR COPIES THEREOF CANNOT BE  
MADE WITHOUT WRITTEN CONSENT.

DRAWN BY: **GHK**  
DATE: 06.27.14

SCALE:  $\frac{3}{4}" = 1' - 0"$



C.R. LAURENCE CO., INC.  
CRL MANUFACTURING  
2100 E. 38TH STREET  
LOS ANGELES, CA 90058



TITLE:  
SOUND TRANSMISSION LOSS TEST  
ELEVATION  
PRODUCT: 8200 HORIZONTAL SLIDING WINDOW

DRAWING NO.  
MU2014-178-02

Sheet No. 1 of 6 Sheets


Test sample complies with these details.  
Deviations are noted.

Report# E2738.01-113-11  
Date 1/27/15 Tech ZPB

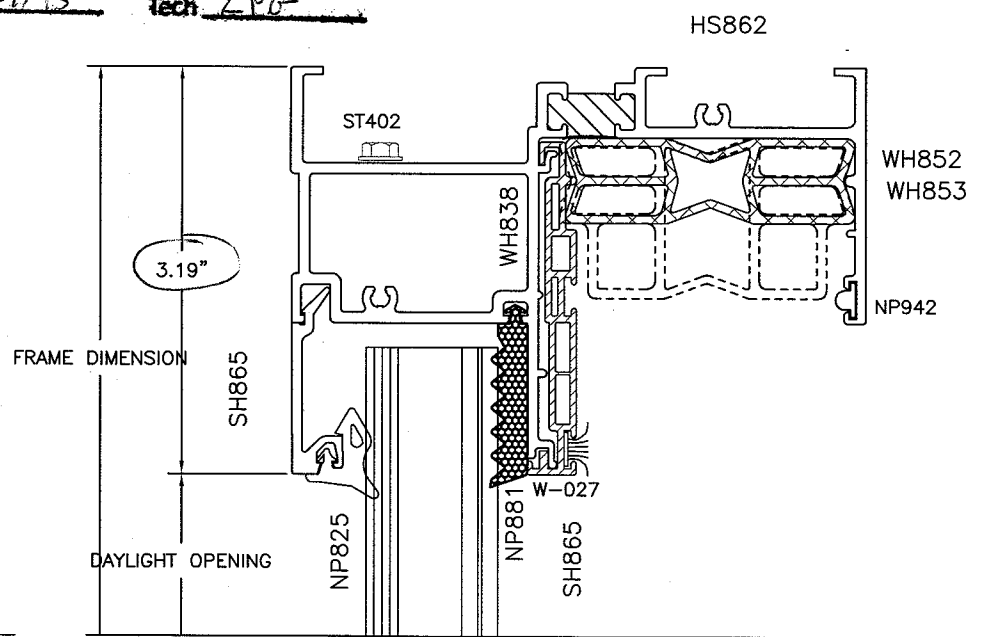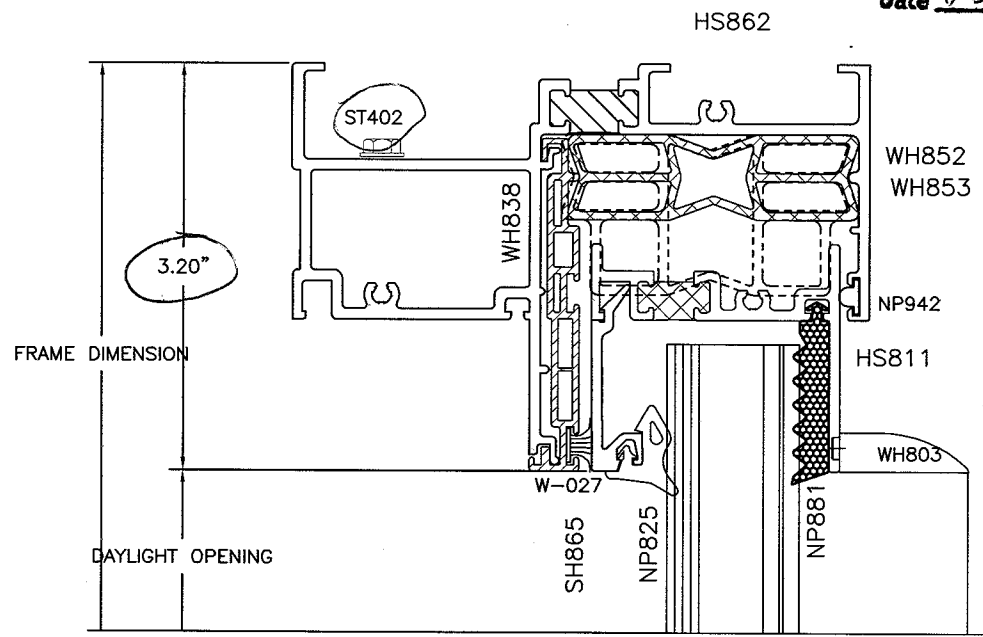

1


2

|      |             |      |    |  |   |   |  |
|------|-------------|------|----|--|---|---|--|
|      |             |      |    | THIS DRAWING AND THE DESIGN SHOWN THEREIN IS THE PROPERTY OF C.R. LAURENCE CO., INC. AND USE OR COPIES THEREOF CANNOT BE MADE WITHOUT WRITTEN CONSENT. |   |  | C.R. LAURENCE CO., INC.<br>CRL MANUFACTURING<br>2100 E. 38TH STREET<br>LOS ANGELES, CA 90058 |
|      |             |      |    | DRAWN BY: GHK<br>DATE: 06.27.14  | TITLE:<br>SOUND TRANSMISSION LOSS TEST<br>HORIZONTAL SECTION<br>PRODUCT: 8200 HORIZONTAL SLIDING WINDOW |   |  |
| REV. | DESCRIPTION | DATE | BY | SCALE: FULL  | Sheet No. 2 of 6 Sheets   |   |  |

Test sample complies with these details.  
Deviations are noted.


Report# E2738.01-113-11  
Date 1/27/15 Tech ZPG

MU2014-178-02

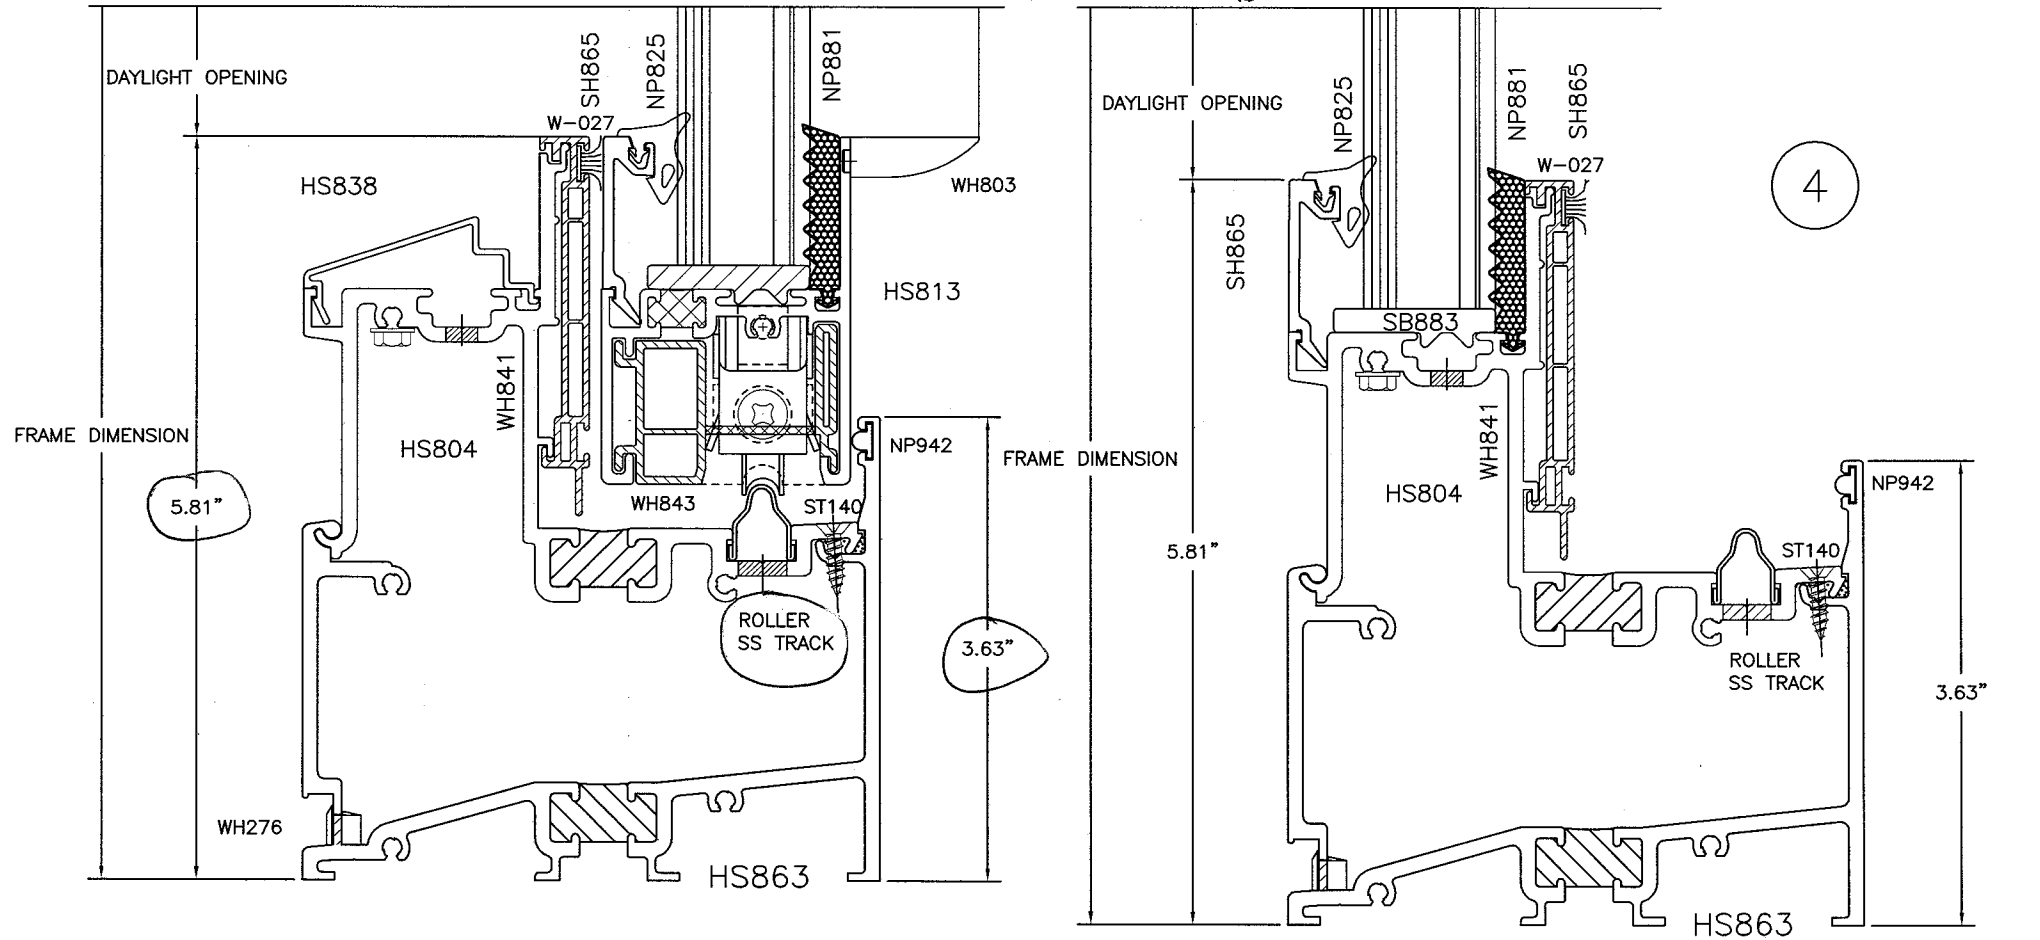

3

4

|      |             |      |    |  |   |   |  |
|------|-------------|------|----|--|---|---|--|
|      |             |      |    | THIS DRAWING AND THE DESIGN SHOWN THEREIN IS THE PROPERTY OF C.R. LAURENCE CO., INC. AND USE OR COPIES THEREOF CANNOT BE MADE WITHOUT WRITTEN CONSENT. |   |  | C.R. LAURENCE CO., INC.<br>CRL MANUFACTURING<br>2100 E. 38TH STREET<br>LOS ANGELES, CA 90058 |
|      |             |      |    | DRAWN BY: GHK  | TITLE:  |   |  |
|      |             |      |    | DATE: 06.27.14   | SOUND TRANSMISSION LOSS TEST<br>VERTICAL SECTION<br>PRODUCT: 8200 HORIZONTAL SLIDING WINDOW | MU2014-178-02   |  |
| REV. | DESCRIPTION | DATE | BY | SCALE: FULL  |   | Sheet No. 3 of 6 Sheets   |  |






6



Test sample complies with these details.  
Deviations are noted.

Report# E2738.01-113-11  
Date 1/27/15 Tech zpb

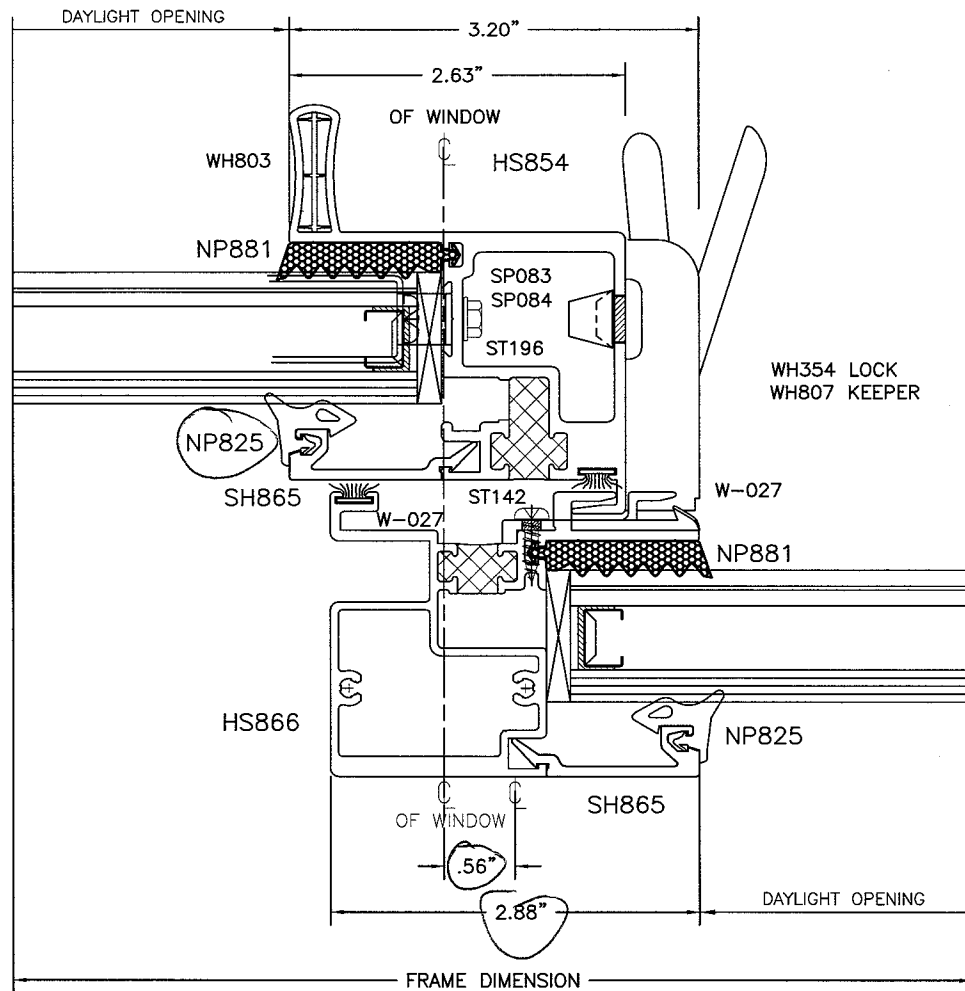

| REV. | DESCRIPTION | DATE | BY |
|------|-------------|------|----|
|      |             |      |    |
|      |             |      |    |
|      |             |      |    |
|      |             |      |    |

THIS DRAWING AND THE DESIGN SHOWN  
THEREIN IS THE PROPERTY OF  
C.R. LAURENCE CO., INC.  
AND USE OR COPIES THEREOF CANNOT BE  
MADE WITHOUT WRITTEN CONSENT.

DRAWN BY: GHK  
DATE: 06.27.14  
SCALE: FULL




C.R. LAURENCE CO., INC.  
CRL MANUFACTURING  
2100 E. 38TH STREET  
LOS ANGELES, CA 90058

TITLE:  
SOUND TRANSMISSION LOSS TEST  
HORIZONTAL SECTION  
PRODUCT: 8200 HORIZONTAL SLIDING WINDOW

DRAWING NO.  
MU2014-178-02  
Sheet No. 5 of 6 Sheets

7

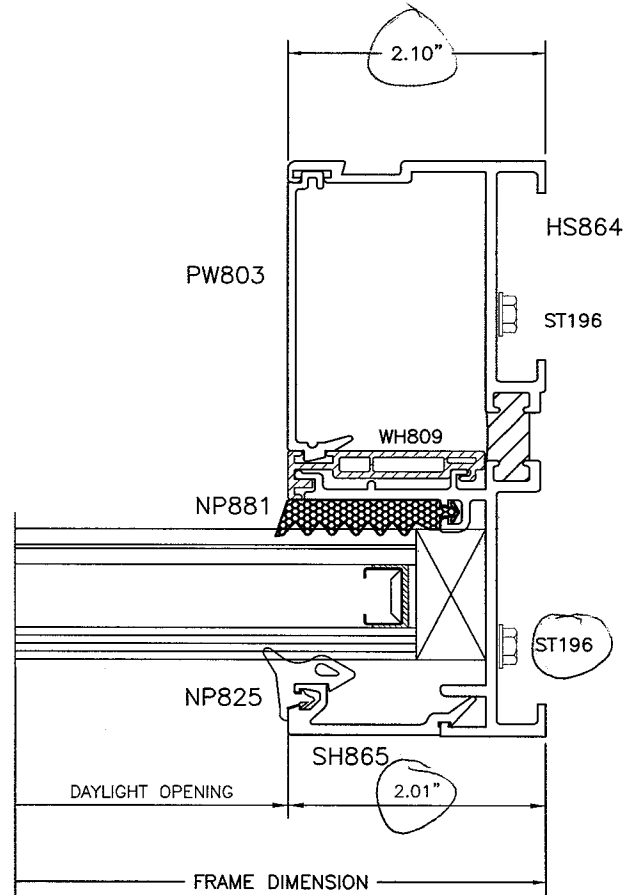

Test sample complies with these details.  
Deviations are noted.

Report# E2738.01-113-11  
Date 1/27/15 Tech ZPB

|      |             |      |    |  |   |  |  |
|------|-------------|------|----|--|---|--|--|
|      |             |      |    | THIS DRAWING AND THE DESIGN SHOWN THEREIN IS THE PROPERTY OF C.R. LAURENCE CO., INC. AND USE OR COPIES THEREOF CANNOT BE MADE WITHOUT WRITTEN CONSENT. |   |  | C.R. LAURENCE CO., INC.<br>CRL MANUFACTURING<br>2100 E. 38TH STREET<br>LOS ANGELES, CA 90058 |
|      |             |      |    | DRAWN BY: GHK<br>DATE: 06.27.14  | TITLE:<br>SOUND TRANSMISSION LOSS TEST<br>VERTICAL SECTION<br>PRODUCT: 8200 HORIZONTAL SLIDING WINDOW |  |  |
| REV. | DESCRIPTION | DATE | BY | SCALE: FULL  |   |  |  |

**Appendix D**

**Photographs**



**Receive Room View of Installed Specimen**



**Source Room View of Installed Specimen**